

CITY OF FRESNO - ADDENDUM NO. 1

CONSTRUCTION OF NORTH AVENUE STREET IMPROVEMENTS, STATE ROUTE 41 TO STATE ROUTE 99 (Fed. No. STPL 5060-061)

BID FILE NO. 2488-10205

NOTICE TO ALL BIDDERS

This Addendum (of 8 pages) is attached to and made part of the above-entitled plans and specifications for the City of Fresno with a bid opening date of **July 1, 2004** at 3:00pm

PLANS AND/OR SPECIFICATIONS

The following changes and additions below will be a part of and subject to provisions of the project plans and/or specifications. The bidder is responsible for recognizing changes to the Bid Proposal as called for on this list of addendum items and shall submit a signed copy of the Addendum No. 1 with the Bid Proposal.

1. REFERENCE INSTRUCTIONS TO BIDDERS, add the following:

Regulated Communications in City Procurement Process Ordinance

The Regulated Communications in City Procurement Process Ordinance (Article 6, Chapter 3 of the Fresno Municipal Code) became effective April 29, 2004. With certain specified exceptions, the Ordinance provides that no Respondent, Bidder, Proposer (as the case may be) shall initiate, engage in, or continue any communication to or with any City elected official concerning or touching upon any matter which is the subject of this competitive procurement process.

Any Respondent, Bidder, Proposer or elected official (as the case may be) who initiates, engages in, continues in, or receives any regulated communication shall file the written disclosure required by the Regulated Communications in City Procurement Process Ordinance.

Any Respondent, Bidder, or Proposer violating the Regulated Communications in City Procurement Process Ordinance may be disqualified from participating in this procurement process and/or determined to be non-responsible. Additionally, the City may set aside the award of a contract, prior to its execution, to a party found to have violated the Ordinance.

Note: The full text of FMC Chapter 3, Article 6 may be viewed on the City's website at <http://www.fresno.gov>, reference link "BID OPPORTUNITIES" and "MAYOR/COUNCIL COMMUNICATIONS ORDINANCE" from there. Additional information can be found under the "FAQs" and "Outline of Ordinance" links on the same page.

2. Specification Page 6.27, section 17.03: Delete reference to A. 170E Controller, Controller Equipment AND 332A Cabinets, and add: **None (No City Furnished Materials)**
3. Specification Page 6.27, Section 17.07: Reference to Standard Drawing E-25 shall be changed to Standard Drawing **E-27**.

4. Specification Page 6.28, Section 17.09: Reference to Standard Drawing E-25 shall be changed to Standard Drawing **E-27**.
5. Specification Page 6.30, Section 17.11: Reference to Standard Drawing E-18 shall be changed to Standard Drawing **E-20**.
6. Specification Page 6.30, Section 17.11: Reference to Standard Drawing E-17 and E-18 shall be changed to **E-19 and E-20**.
7. Specification Page 6.40, Section 17.24, paragraph 3: Reference to #10 shall be changed to **#8**.
8. Signal Plan sheet nos. 28, 29, & 30, typical Construction note 7: Reference to sheet E-4 shall be changed to sheet **No. 31 and 32**.
9. General Note: Bidders shall reference and use the most recent City Standards Specifications and Drawings which can be purchased at the Public Works counter or viewed on the City of Fresno website: www.ci.fresno.ca.us. These new standards shall supercede any references or conditions to outdated City Specifications and Drawings.
10. Streetlight Plan Sheet No. 25: As a clarification, the streetlight at Sta. 42+88 is **150W**.
11. Streetlight Plan Sheet No. 27: As a clarification, the streetlight at Sta. 70+33 is **70W**.
12. Add: Bid Question form (Addendum No. 1): Response to question #1, and per Item 18 of this Addendum #1.
Note: Attached to this addendum is original response to Question #1.
13. Add: Exhibit 1A, Addendum No. 1 (Typical Section modification)
14. Add: Exhibit 1B, Addendum No. 1 (Street Plan modification)
15. Add: Exhibit 1C, Addendum No. 1 (Street Plan modification)
16. Add: Exhibit 1D, Addendum No. 1 (Street Plan Modification)
17. Street Plan Sheet 21, Detail F/21: Reference to "12" RCP" shall be changed to "**12" PVC PIPE**".
18. Bid Form Page 1.2B, Bid Item No. 25: Reference to "20-foot" shall be changed to "**22-foot**".

19. Specifications Page 7.7, Section 1.26: All references to "20-foot" shall be changed to "**22-foot**". Chain link drive gates shall be 22 feet wide.

20. Specifications Page 7.6, Section 1.21: Add the following sentence:

This bid item includes the removal of existing street lights to be replaced with new street lights, where the removal and replacement of existing street lights is specifically shown on the Plans.

21. Specifications Page 7.3, Section 1.10: Add the following sentence:

This bid item includes Asphalt Concrete Dike, Type E, where Asphalt Concrete Dike, Type E is specifically shown on the Plans. (Sta. 25+50 to Sta. 26+50, 100 L.F.)


Michael T. Kim, P.E.
City Engineer

6/17/04
Date

The bidder shall sign below indicating he has thoroughly read and understands the contents of this Addendum No. 1.

Date: _____ Signed: _____


City of



PURCHASING DIVISION
TELEPHONE # (559) 621-1332
FAX # (559) 488-1069

BID QUESTIONS FOR: CONSTRUCTION OF NORTH AVENUE STREET IMPROVEMENTS, STATE ROUTE 41 TO STATE ROUTE 99 Bid File: 2488-10205 Attention: Paul Schramm, Supervising Buyer		(FOR CITY OF FRESNO USE ONLY) QUESTION No: <u>1</u> Date: <u>6/10</u> Reviewed By: <u>(PS)</u> RESPONSIBLE FOR RESPONSE: <input type="checkbox"/> CITY <input checked="" type="checkbox"/> CONSULTANT	
FROM: <u>Haydon Construction</u>		DATE: <u>6-10-04</u> PHONE No: <u>251-5522</u> FAX No: <u>251-6933</u> CONTACT PERSON: <u>John DeVolt</u>	
QUESTIONS: <u>Detail F/21 Calls for tnc 12" Pipe to</u> <u>be RCP and Tnc Specifications and Bid form</u> <u>call for PVC. Please Clarify Type Pipe</u> <u>Required.</u>			
ANSWER: _____			
<u>PIPE SHOWN IN DETAIL F/21 AS "12" RCP" SHOULD</u> <u>BE "12" PVC PIPE". REFER TO ADDENDUM NO. 1.</u>			
RESPONSE BY: <u>K. K. Bair, Church & Flynn</u> DATE: <u>6/17/04</u>			
INCLUDED IN ADDENDUM No. _____ DATE: _____			

6/17/04

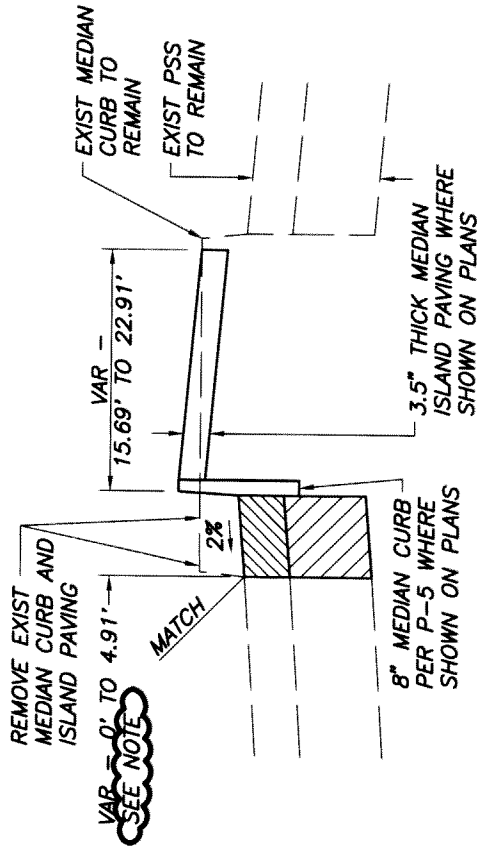


B MEDIAN RECONSTRUCTION
5 NOT TO SCALE

NOTE: WHERE DISTANCE IS 2' OR LESS, A 12-INCH THICK FULL-DEPTH AC SECTION SHALL BE USED. WHERE DISTANCE IS GREATER THAN 2', PSS NO. 2 SHALL BE USED.


ADDENDUM NO. 1: EXHIBIT 1A

(MODIFICATIONS TO TYPICAL SECTIONS SHEET NO. 5)

 6/17/04



(MODIFICATIONS TO NORTH AVENUE PLAN AND PROFILE SHEET NO. 10)

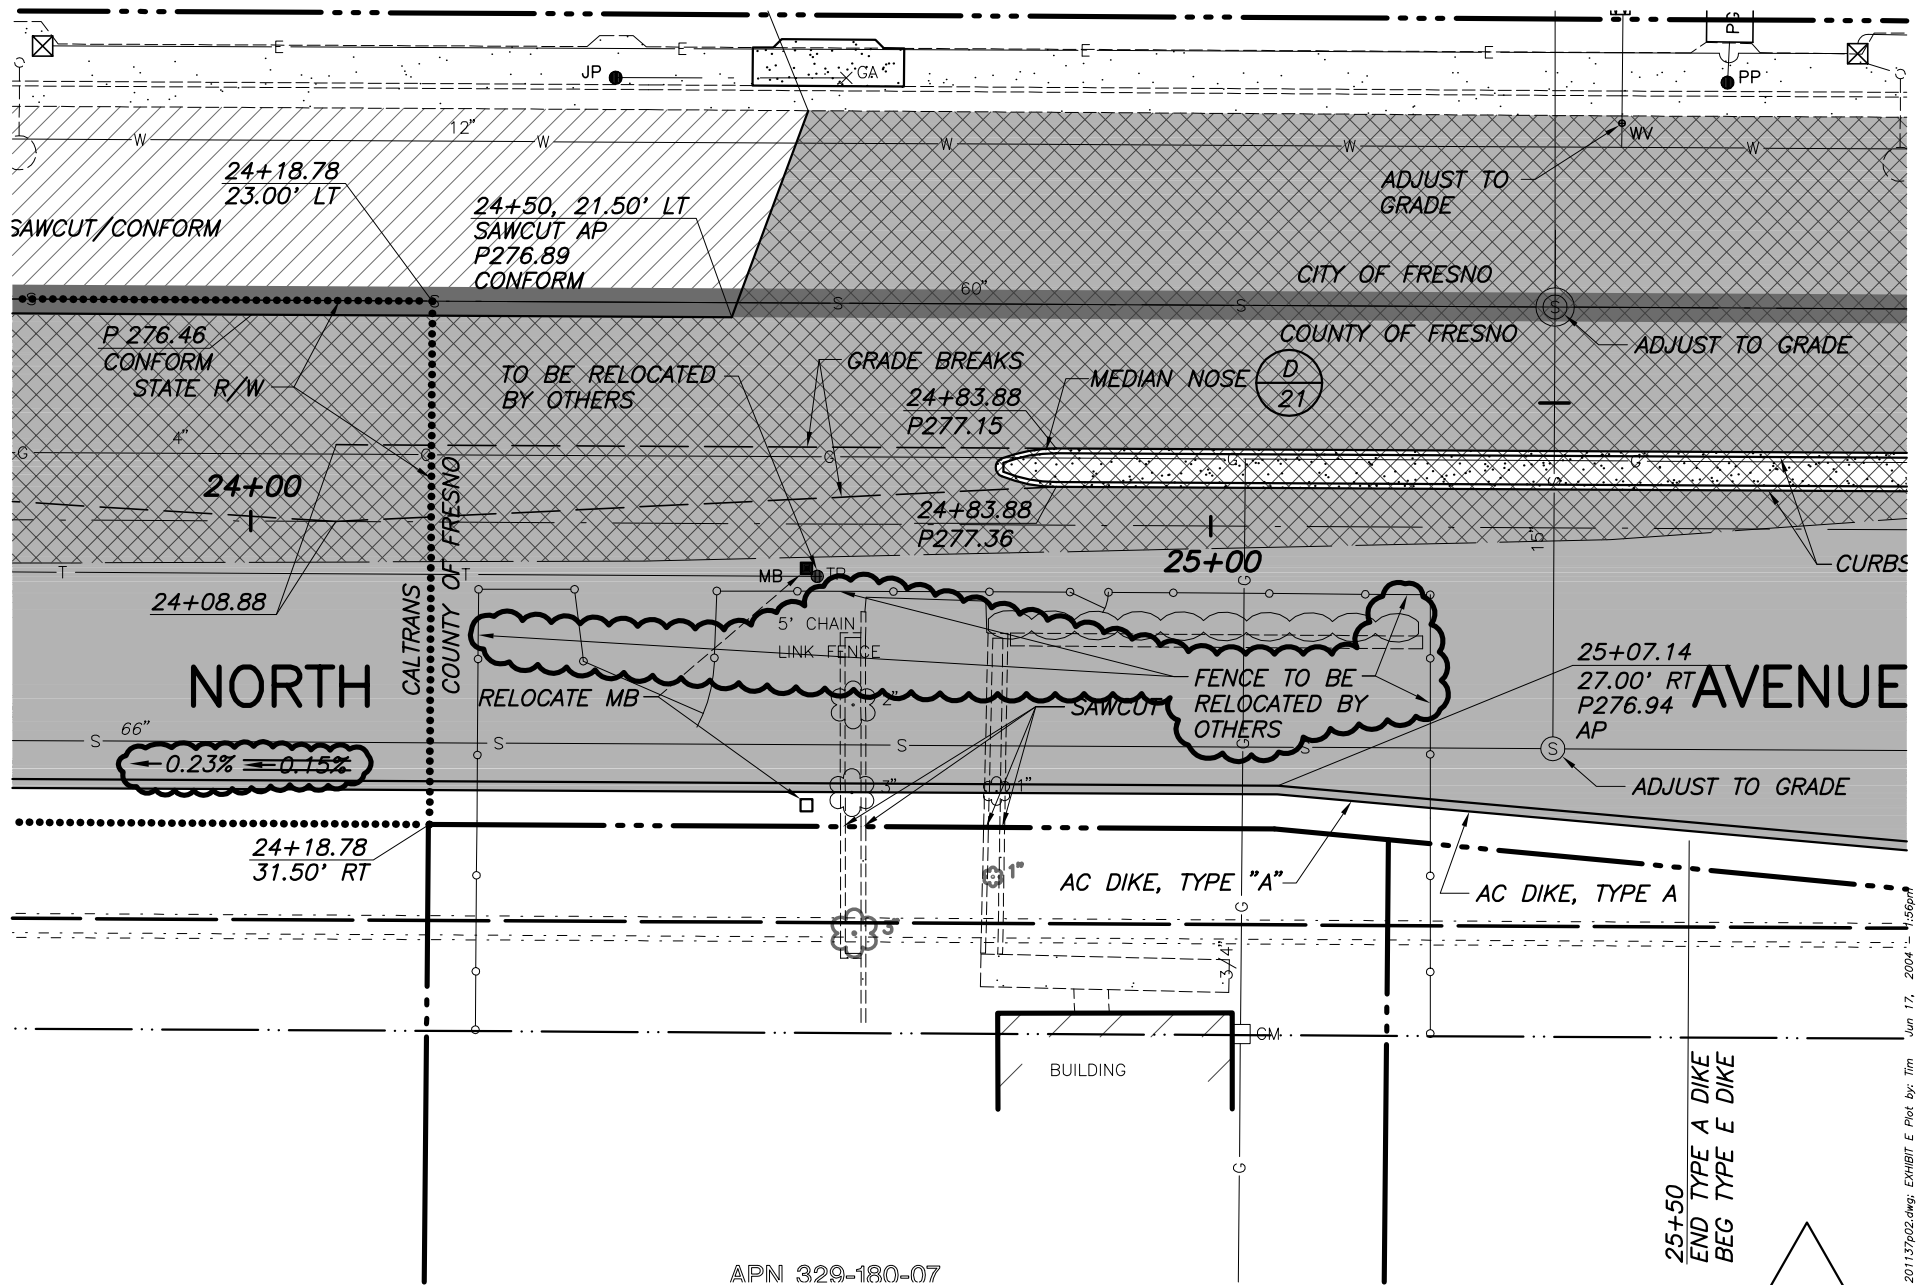

ADDENDUM NO. 1: EXHIBIT 1D

(MODIFICATIONS TO NORTH AVENUE PLAN AND PROFILE SHEET NO. 7)

